

**LEGEND**


- PROPERTY INLETS TO BE CONSTRUCTED AS PER TYPE B (REFER TO EDM 702), TO BE CONVERTED TO TYPE A (REFER TO 703) IN STAGE 7
- CONNECTION POINT FOR FUTURE PROPERTY INLET TO BE PROVIDED IN PIT. FUTURE PROPERTY INLET TO BE CONSTRUCTED IN STAGE 7

**SERVICE LOCATION TABLE**

| ROAD NAME                         | WATER (DW) |        | WATER (NDW) |        | GAS  |        | NBN (TELECOM) |        | ELECTRICITY |        |
|-----------------------------------|------------|--------|-------------|--------|------|--------|---------------|--------|-------------|--------|
|                                   | SIDE       | OFFSET | SIDE        | OFFSET | SIDE | OFFSET | SIDE          | OFFSET | U/G CABLE   | OFFSET |
| BROSSARD ROAD (LOT 632 - LOT 634) | N/W        | 2.55   | S/E         | 2.00   | N/W  | 1.80   | N             | 0.80   | S/E         | 3.40   |
| BROSSARD ROAD (LOT 627 - LOT 622) | N/W        | 2.55   | S/E         | 2.00   | N/W  | 1.80   | S/E           | 0.80   | S/E         | 3.40   |
| JANOLI STREET                     | W          | 3.10   | W           | 2.60   | W    | 2.20   | E             | 1.80   | E           | 2.60   |
| ALICE AVENUE                      | E          | 3.10   | E           | 2.60   | E    | 2.20   | W             | 0.80   | W           | 2.30   |
| ROBIN ROAD                        | S          | 3.10   | S           | 2.60   | S    | 2.20   | S             | 0.80   | N           | 0.80   |
| JOY DRIVE (LOT 610 - LOT 608)     | W          | 3.10   | W           | 2.60   | W    | 2.20   | E             | 1.80   | E           | 2.30   |
| JOY DRIVE (LOT 607 - LOT 601)     | W          | 3.10   | W           | 2.60   | W    | 2.20   | E             | 1.80   | E           | 2.60   |
| STRATHMORE WAY                    | S          | 3.10   | S           | 2.60   | S    | 2.20   | N             | 1.80   | N           | 2.30   |
| HERON DRIVE                       | N          | 3.10   | N           | 2.60   | N    | 2.20   | S             | 1.80   | S           | 2.30   |

1. TELECOMMUNICATIONS AND ELECTRICITY CABLES TO BE CONSTRUCTED IN A COMMON TRENCH IN ACCORDANCE WITH ELECTRICITY AUTHORITY STANDARD DRG'S.  
 2. GAS AND WATER MAINS TO BE CONSTRUCTED IN A COMMON TRENCH.

| Rev | Description   | M.R.     | Date     |
|-----|---|----------|----------|
| 3   | AS CONSTRUCTED  | M.T.     | 18-02-20 |
| 2   | UPDATED HERON DRIVE NBN & ELEC OFFSETS                                  | M.T.     | 14-05-19 |
| 1   | AMENDED LOT 612 GW CONDUIT, NBN & ELEC OFFSETS & SERVICE LOCATION TABLE | M.T.     | 19-03-19 |
| 0   | ISSUED FOR CONSTRUCTION   | M.R.     | 09-01-19 |
| E   | AMENDMENT TO EASEMENT AND PROPERTY INLETS                               | M.R.     | 12-12-18 |
| D   | AMENDMENT TO FOOTPATH SURROUNDING RESERVE                               | M.R.     | 20-11-18 |
| C   | ISSUED FOR TENDER   | M.R.     | 05-10-18 |
| B   | REVISED PROPERTY CONNECTIONS, SERVICE LOCATIONS & SERVICE TABLE         | M.R.     | 18-09-18 |
| A   | Amendments  | Approved | Date     |

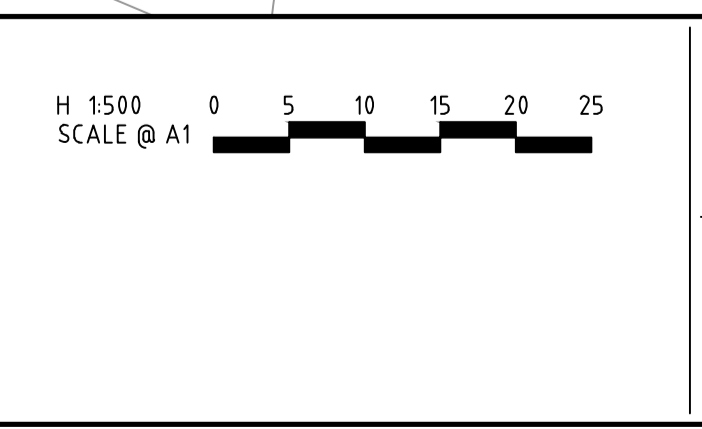

© Spiire Australia Pty Ltd All Rights Reserved  
 This document is produced by Spiire Australia Pty Ltd solely for the benefit of and use by the client in accordance with the terms of the retainer. Spiire Australia Pty Ltd does not and shall not assume any responsibility or liability whatsoever to any third party arising out of any use or reliance by third party on the content of this document.

469 La Trobe Street PO Box 16084 Melbourne  
 Victoria 3007 Australia T 61 3 9993 7888  
 spiire.com.au ABN 55 050 029 635

Designed  
M.SHIRLEY  
 Authorised  
M.READMAN  
 Checked  
J.KOEHLER  
 Date  
14/09/18

**TRIJENA**  
 STAGE 6  
 ROAD & DRAINAGE  
 SERVICES PLAN  
 HUME CITY COUNCIL  
 PGG (MICKLEHAM) PTY LTD  
**AS CONSTRUCTED** Drg No 304010CR201 Rev 3

file name: 304010CR201.dwg; layout: PGG\_CD201; plotted by: Michael Francis; plot date: 18/02/2020 10:07 AM; sheet: 3 of 31 sheets