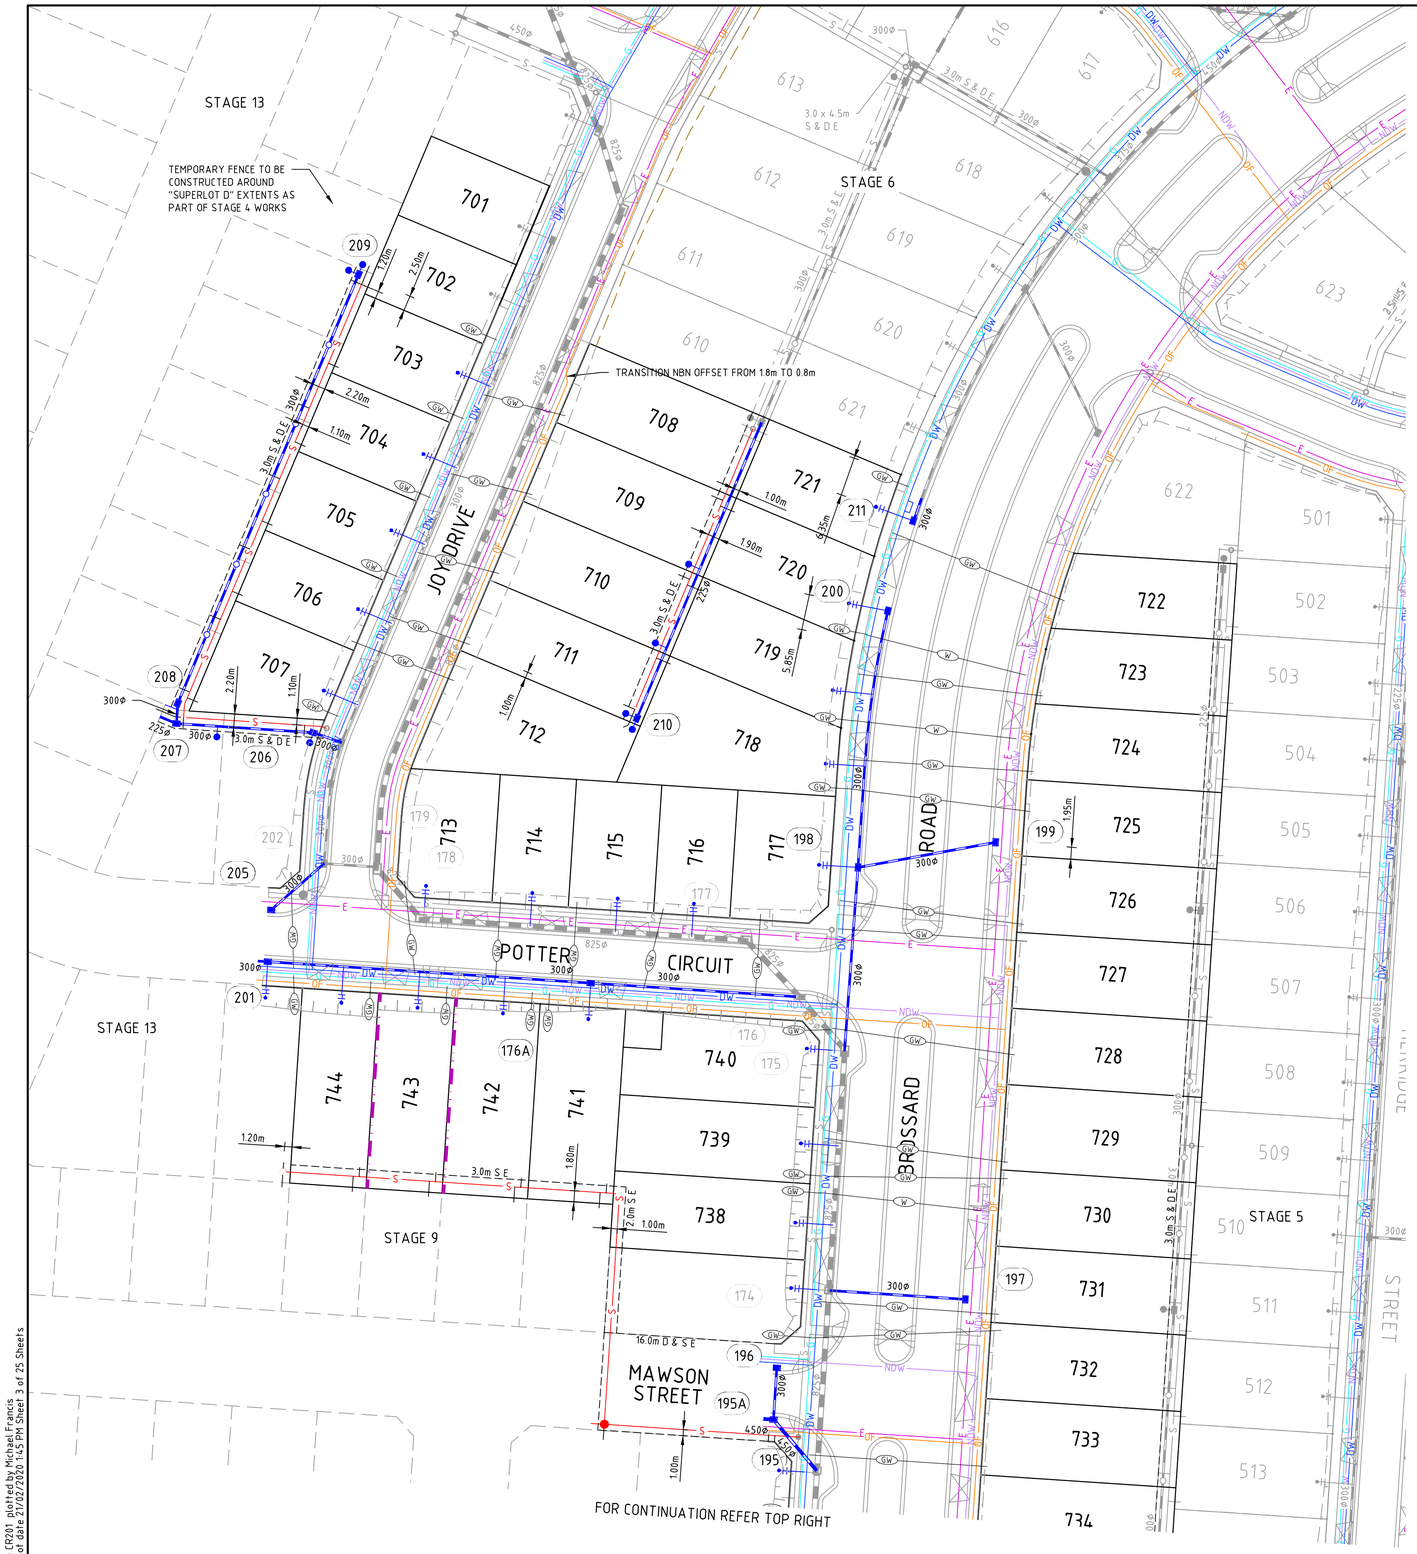

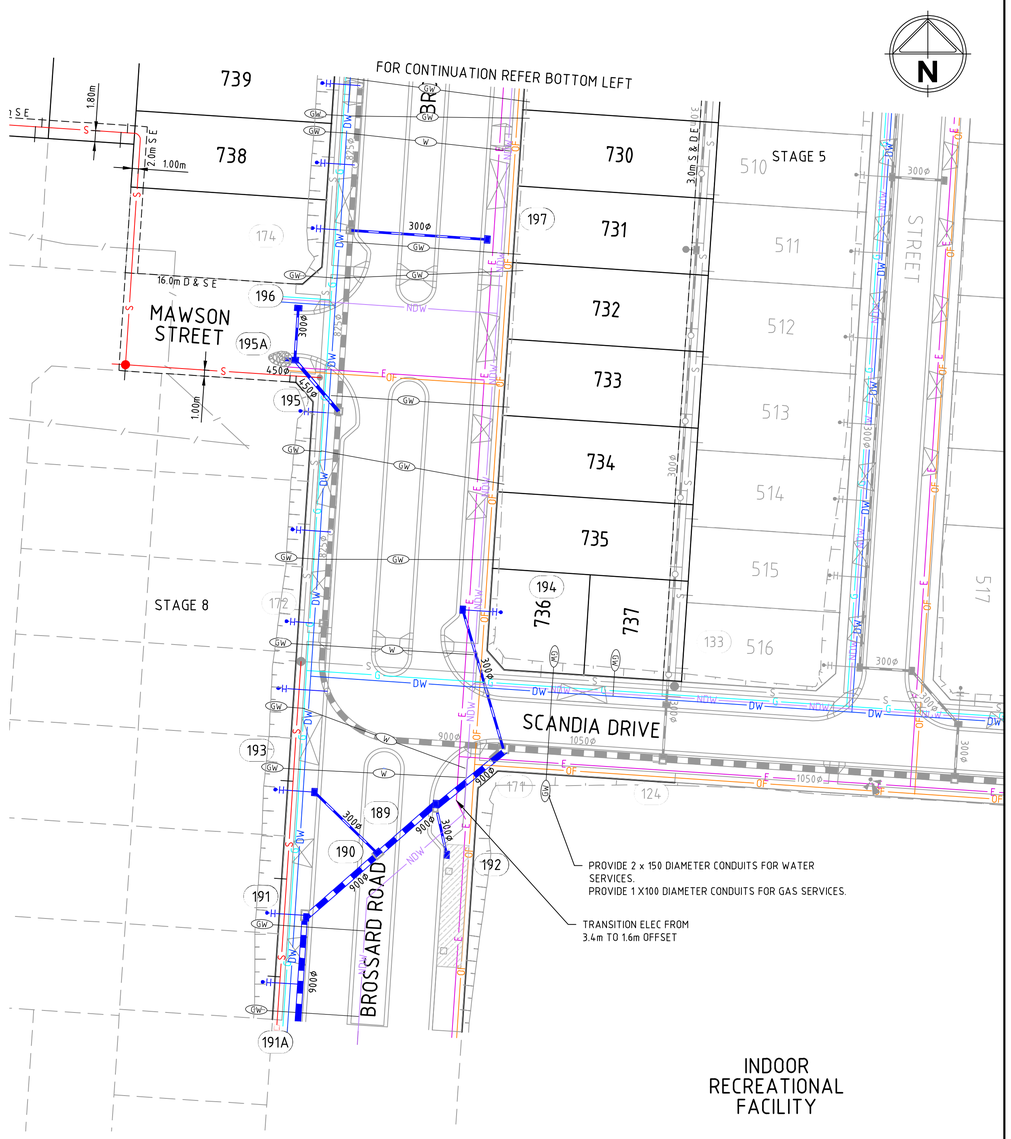

LEGEND

- EXISTING TYPE B PROPERTY INLETS (REFER TO EDCM 702). TO BE CONVERTED TO TYPE A PROPERTY INLETS (REFER TO 703)
- EXISTING CONNECTION POINT. TO BE EXTENDED AND CONVERTED TO TYPE A PROPERTY INLET (REFER TO 703)

SERVICE LOCATION TABLE

ROAD NAME	WATER (DW)		WATER (NDW)		GAS		NBN (TELECOM)		ELECTRICITY U/G CABLE	
	SIDE	OFFSET	SIDE	OFFSET	SIDE	OFFSET	SIDE	OFFSET	SIDE	OFFSET
BROSSARD ROAD (NORTH OF SCANDIA DRIVE)	W	2.55	E	2.00	W	1.80	E	0.80	E	3.40
BROSSARD ROAD (SOUTH OF SCANDIA DRIVE)	W	2.55	W	14.10	W	1.80	E	0.80	E	1.60
JOY DRIVE	W	3.10	W	2.60	W	2.20	E	0.80	E	2.30
POTTER CIRCUIT	S	3.10	S	2.60	S	2.20	S	0.80	N	2.30
MAWSON STREET	N	3.10	N	2.60	N	2.20	S	1.80	S	2.40
SCANDIA DRIVE	N	3.10	N	2.60	N	2.20	S	0.80	S	1.90

1. TELECOMMUNICATIONS AND ELECTRICITY CABLES TO BE CONSTRUCTED IN A COMMON TRENCH IN ACCORDANCE WITH ELECTRICITY AUTHORITY STANDARD DRG's.
2. GAS AND WATER MAINS TO BE CONSTRUCTED IN A COMMON TRENCH.

Rev	Amendments	Approved	Date
4	AS CONSTRUCTED.	M.T.	21-02-20
3	AMENDED SIDE BATTERS	M.T.	23-01-20
2	BREAKOUT BAYS REMOVED, MAWSON ST ELEC OFFSET AMENDED	M.T.	07-01-20
1	ADDED ELECTRICAL BREAKOUT BAYS, AMENDED ELEC & NBN OFFSET	M.T.	19-11-19
0	ISSUED FOR CONSTRUCTION	M.T.	28-08-19
F	AMENDED NOTES, BOUNDARY BATTERS & GW CONDUITS	M.T.	13-08-19
E	AMENDED SERVICES, CONDUITS & CONCRETE FOOTPATH	M.T.	22-07-19
D	ISSUED FOR TENDER	M.T.	14-06-19

H 1:500 SCALE @ A1 0 5 10 15 20 25

© Spiire Australia Pty Ltd All Rights Reserved
This document is produced by Spiire Australia Pty Ltd solely for the benefit of and use by the client in accordance with the terms of the retainer. Spiire Australia Pty Ltd does not and shall not assume any responsibility or liability whatsoever to any third party arising out of any use or reliance by third party on the content of this document.

spiire
469 La Trobe Street PO Box 16084 Melbourne Victoria 8007 Australia T 61 3 9993 7888
spiire.com.au ABN 55 050 029 635

POTTER GEORGE TRIJENA MICKLEHAM

Designed W.MAY
Checked J.KOEHLER
Authorised M.TOOMER-SMITH
Date 01-05-19

TRIJENA STAGE 7
ROAD & DRAINAGE SERVICES PLAN
HUME CITY COUNCIL
PGG (MICKLEHAM) PTY LTD

AS CONSTRUCTED
Drg No **304011CR201**
Rev **4**

file name 304011CR200.dwg layout name CR201 plotted by Michael Francis
file location G:\30\304011\Civil\ACAD plot date 21/02/2020 1:45 PM Sheet 3 of 25 Sheets